# **CHANGE ORDER**

<ul><li>✓ Owner</li><li>✓ Architect</li><li>✓ Contractor</li><li>✓ O.P.M</li><li>☐ CX Agent</li></ul>	☐ Civil ☐ Landscap ☐ Geotech ☐ Structura ☐ MEP-FP	☐ Aco	tainability ustics er	DORE + WHITTIER
Project Name:	Haverhill C School	onsentino Middle	CO No.	08
Architect's Project No.	21-0818			
Owner:	City of Hav 4 Summer Haverhill, N	Street	Architect:	DORE + WHITTIER  260 Merrimac St, Bldg 7, Newburyport, MA 01950
To:		ers Corporation	Issue Date	2/13/2025
	57 Rockwo Marshfield		Contract Date:	4/1/2024
Attention:	TJ Dahill			
See attached list of 1 it	tem(s) for a t	otal of		\$ <u>26,433.98</u>
Not valid until signed b	by both the C	wner and Architec	t.	
Signature of the Contractor	indicates his agı	reement herewith, inclu	ding any adjustmen	at in the Contract Sum or Contract Time.
The original Contract S	Sum was			\$ <u>113,750,000.00</u>
Net change by previou	ısly authorize	ed Change Orders		\$ <u>135,571.92</u>
The Contract Sum prio	r to this Cha	nge Order was		\$ <u>113,885,571.92</u>
The Contract Sum will	be <u><b>INCREASE</b></u>	<u>ED</u> by this Change (	Order	\$ <u>26,433.98</u>
The new Contract Sum	including th	is Change Order wi	ll be	\$ <u>113,912,005.90</u>
The Contract Time will	be changed	by		(0) days
The Date of Substantia	al Completion	as of the date of t	his Change Ord	er therefore is <mark>Friday, April 30, 2027</mark>
AUTHORIZED:				
ARCHITECT:		OWNER:		CONTRACTOR:
DORE + WHITTIER 260 Merrimac St, Bldg 7, N MA 01950	ewburyport,	Mayor Melinda E Bar 4 Summer St Suite 10 Haverhill, MA 01830		Brait Builders Corporation 57 Rockwood Road Marshfield, MA 02050
				Name: TJ Dahill
BY:	tally signed by Day 14 M	BY:		Title: Project Manager
Date: Walter Walter	C= <del>US,</del> walter@doreandwhittier.com, Dore + Whittier", CN=Donald	Date:		Date: February 25, 2025
Certification of Approximate Adequate fing in an a	) P   7   7   15   29   17   17   18   19   19   19   19   19   19   19	r M.G.L. c44, s31C: ent to cover the total	cost of this	

Change Ord

CCD / PR / PCO #	Description	Amount
PCO 044 R1	Connector C Stairs	\$ 26,433.98
Total		\$26,433.98

Copies of supporting documentation for each item listed above is attached following.

### **PCO REVIEW FORM**

Project Name: Haverhill Consentino Middle

School

Architect's Project No. 21-0818

PCO No.



Subject: Connector C Stairs PCO Issue Date: 2024.12.07

PCO Reviewed: **2025.02.13** 

The following is a summary of the Design Team review of the above referenced Proposed Change Order (PCO). Refer to summary below *and* attached comments. Acceptance of this PCO – or partial acceptance – shall not constitute a change to the construction contract or a directive to proceed with the work. PCO review is only a recommendation to the Owner regarding the validity and cost of the proposed PCO. Final approval shall be by the Owner per contract.

CATEGORY						
Elective / Owner		Town/AHJ/Other		Unforeseen		
Design	X	Other		GC Expenditure		

PCO shall be reviewed by each consultant with relevant work included:

Reviewed	Revise	Rejected	Consultant:	Reviewer:	Comments:
Х			Architectural:	T. King / M. Rogers	D <b>+W</b> has reviewed the attached PCO
					and recommends approval at this time
			Site/Civil:		
			Traffic:		
			Geotechnical:		
			Landscape:		
			Wetlands:		
			Haz Materials:		
			Structural:	EDG	Previously reviewed – comments
					address
			Acoustical:		
			Foodservice:		
			Fire Protection:		
			Plumbing:		
			HVAC:		
			Electrical:		
			Lighting:		
			Telecomm:		
			Building Security:		
			Audio-Visual:		
			Theatrical:		
			Door Hardware:		
			Sustainability		
			Other:		

	Х	Design Team Recommends Approval
Michele Barbaro-Rogers		Design Team <b>Does Not</b> Recommend Approval

### **Michele Rogers**

From: T.J. Dahill <tdahill@braitbuilders.com>
Sent: Friday, January 24, 2025 1:54 PM

**To:** Michele Rogers; Jake McDonough; Suzanna Yeung; Charlie Kanouff;

cesar.collado@collierseng.com; angela.campbell@collierseng.com

**Cc:** Tara King

**Subject:** RE: Haverhill - Consentino PCO 44R1 Compiled.pdf

**Attachments:** PCO 44R1 Compiled.pdf

Please see below responses:

#### <u>V&G:</u>

PCO 44R1 If you look at this, it's not just one column as stated in the architects comments It is also 4 benches that are powder coated.

We have 32 man hours that is two men for two day or two men first day and one man two more days ,This is not excessive .

Knowing that the benches will not be installed at the same time as the stair and stair column.

#### **Procraft:**

The field labor will involve two men for two days. The original bench is just set in place. The new bench requires fastening through the metal frame from underneath at many locations. In addition, the field joint locations of the larger bench require clamping and tight joint fasteners from underneath. Contact me for further clarification and discussion.

We concur with the response from both subcontractors and ask the pricing be reevaluated for approval. Please advise if a call is required.

Thx.

ΤJ

From: Michele Rogers <mrogers@DoreandWhittier.com>

Sent: Wednesday, January 15, 2025 3:54 PM

To: T.J. Dahill <tdahill@braitbuilders.com>; Jake McDonough <jmcdonough@braitbuilders.com>

Cc: Tara King <tking@DoreandWhittier.com>

Subject: Haverhill - Consentino PCO 44R1 Compiled.pdf

TJ

Please see the comments on the attached PCO – the comments in blue are from CPL and red are DW and EDG comments.

Let me know if you have any questions

Michele Barbaro Rogers, AIA,NCARB,CPTED

**Senior Associate** 

**DORE + WHITTIER** 

doreandwhittier.com

(978) 499-2999 x 314

(978) 360-4019 mobile

# Brait Builders Corp.

57 Rockwood Road Suite 3

Phone: (781) 837-6400 Marshfield, MA 02050 Fax: (781) 837-6153 PROPOSED CHANGE ORDER No. CMS-044R1

TITLE:

TO:

PR-32 Connector C Stairs

DATE: 12/07/2024

PROJECT: Dr. Albert B. Consentino Middle

JOB: CSM-2024

School

City of Haverhill

**CONTRACT NO:** 

685 Washington Street

Haverhill, MA

#### DESCRIPTION OF CHANGE

Costs associated with PR-32 Connector C Stairs.

Ite m	Description	Quantity	Units	Unit Price	Labor Burden	Burden Amount	Net Amount
1	V&G CO#03	1	LS	\$17,007.59		\$0.00	\$17,007.59
2	Procraft PR-32 COR	1	LS	\$7,674.00		\$0.00	\$7,674.00
3	Brait - OH&P - 5%	0	%	\$24,681.59		\$0.00	\$1,234.08
4	Brait - Bond - 2%	0	%	\$25,915.67		\$0.00	\$518.31

**Lump Sum:** 

\$26,433.98

Total:

\$26,433.98

Dore & Whittier By:	Brait Builders By:
City of Haverhill	T.J. Dahill
Date:	Date: December 7, 2024
City of Haverhill	Owners Project Manager
By: Monsue	By: And la Comphill
Date: 2/25-/23	Date: 2-19-2025

Contractor to provide more accurate break down for adding a post to support the stairs. It is unclear why it would take 4 additional days to fabricate the post and 4 additional days to install the post in the field. The costs shall be clarified.

Additionally, the use of a field truck for 3 days appears excessive.

Updated response: Contractor has provided additional information to address this issue and other comments noted here in the attached email. D+W finds the fees and explanations to acceptable

# **V& G IRON WORKS INC.**

Date: October 31, 2024

Project Name: Constantino Middle School

**Brait Construction** 

Proposal request Ref No: 3

Request for Change order
PR 032 Credit cane rail and add for column and bench frames

Description:

### Work of Sub-subcontractors:

Subcontractor:	Quantity	Unit	Rate	Total
Hot dip galv		lbs	\$1.75	\$0.00
Trucking to and from galv			\$750.00	\$0.00
				\$0.00

Work of the Subcontrcator Contractor:

CONSIDERABLY HIGH.

CPL: HIGH

Labor: Base rate							
Trade Classification:		Description of Work		Y Hrs: Y	<b>Unit</b>	Rate:	Yotal; Y
05 50 00	$\overline{}$	Detailing/PM		16	hrs	\$100.00	\$1,600.00
05 50 00		Shop Fabrication		32	hrs	\$204.08	\$6,530.56
05 50 00		Field install		32	hrs	\$140.00	\$4,480.00
05 50 00	Ч	Credit fab for cane ra	ر بر راند	<u> </u>	X X bys X X	\$204.Q8 }	<u> </u>
05 50 00		Credit install cane ra	iil	-8	hrs	\$140.00	-\$1,120.00
					hrs	\$0.00	\$0.00
					Labor Subtotal:		\$9,857.92
CPL: PRICE	SAF	RE I			Labor Burden	30%	\$2,957.38
CONSIDERARI V LIGH				Labor Base Rate total:	•	\$12,815.30	

Materials:					
Material Description:	Mat Qty:	Unit:	Unit Price:	Total:	
1 1/2" x 1/2" flatbar	200	lbs	\$2.50	\$500.00	
1 1/2" x 3/4" HSS	150	lbs	\$2.50	\$375.00	
1" x 1/2" flatbar	50	lbs	\$2.50	\$125.00	
Credit 1 1/4" pipe for cane rail	-125	lbs	\$2.50	-\$312.50	
4 x 4 x 1/4" HSS column	130	lbs	\$2.50	\$325.00	
			Material Subtotal:	\$1,012,50	

Equipment:						
Equipment Description:	Eqp. Qty:	Unit:	Unit Price:	Total:		
Field Truck	3	days	\$761.00	\$2,283.00		
shipments/ deliveries		trips	\$750.00	\$0.00		
Credit truck for install cane rail	-0.5	days	\$761.00	-\$380.50		
		E	quipment Subtotal:	\$1,902.50		
	Total Sub-S	Subcontractor Cos	ts:	\$15,730.30		

Subcontractor Mark up:

Subtotal:

10.00%

\$1,277.29 \$17,007.59

\$15,730.30

Total



Architectural Millwork ·

Materials

PM/Eng.

10% M/U

Sub-Total

Shop Labor

Field Labor

**Custom Cabinetry** 

TJ Dahill Brait Construction Managers

12/05/24

### PROCRAFT CORPORATION

416 River Rd. • PO Box 298 New Boston, NH 03070 www.procraftcorp.com Phone: 603-487-2080

Fax: 603-487-2086

RE: Consentino Middle School Haverhill, MA

# **Change Order Request**

We propose to Furnish and Install the following changes per PR\_32 dated 10/21/24.

HOW MANY HOURS?

\$ 1,220.00

\$4,050.00

\$ 4,000.00

\$ 600.00

\$ 987.00

\$ 10,857.00

Add solid wood bench seats under Stair 5 Level 1 and Corridors 1003 & 2021.

A break down of 4K in field labor would be helpful in review of PCO

Assumed labor to install new bench vs old bench (14'-0) would be the same, plus additional 18'-0 of bench

Field labor -- \$28 per LF of bench in Credit vs \$125 per LF for new?

• Delete contract wood benches at Corridors 1063 & 2021.

Materials <\$ 914.00> Shop Labor <\$ 1,869.00> Field Labor <\$ 400.00> Sub-Total <\$ 3,183.00>

No credit back on M/U? Assume 10% was kept from original benches? Add 318 to credit?

#### Exclusions:

- Tax
- Steel support frames, including installation

#### TOTAL FURNISH AND INSTALL \$ 7,674.00

ProCraft reserves the right to withdraw or revise this proposal if not accepted within 7 days of bid date.

Contract subject to Material Escalation Clause

Thank you,

Gary Benoit gbenoit@procraftcorp.com



### PROPOSAL REQUEST

ROPOSAL R				
Owner Architect Contractor O.P.M CX Agent	<ul><li>☐ Civil</li><li>☐ Landscape</li><li>☐ Geotech</li><li>☑ Structural</li><li>☐ MEP-FP</li></ul>	□ Su: □ Acc	stainability oustics her	DORE + WHITTIEF
oject Name:	Haverhill Consenting	o Middle	PR No.	32
chitect's Project No.	21-0818			
vner:	City of Haverhill 4 Summer Street Haverhill, MA 01830		Architect:	DORE + WHITTIER  260 Merrimac St, Bldg 7, Newburyport, MA 01950
:	•	ration	Contract Date	4/1/2024
	57 Rockwood Road Marshfield, MA 0205	50	Issue Date:	10/21/2024
ention:	TJ Dahill		Subject:	Connector C Stair
	Architect Contractor O.P.M CX Agent oject Name: chitect's Project No. vner:	Architect ☐ Landscape Contractor ☐ Geotech O.P.M ☐ Structural CX Agent ☐ MEP-FP  Dject Name: Haverhill Consenting School  Chitect's Project No. 21-0818  Viner: City of Haverhill 4 Summer Street Haverhill, MA 01830  Brait Builders Corpol 57 Rockwood Road Marshfield, MA 0205	Architect	Architect ☐ Landscape ☐ Sustainability Contractor ☐ Geotech ☐ Acoustics O.P.M ☐ Structural ☐ Other  CX Agent ☐ MEP-FP ☐ Other  Oject Name: Haverhill Consentino Middle PR No. School  Chitect's Project No. 21-0818  Viner: City of Haverhill Architect: 4 Summer Street Haverhill, MA 01830  E Brait Builders Corporation Contract Date 57 Rockwood Road Marshfield, MA 02050

Please submit an itemized quotation for changes in the Contract Sum and/ or Time incidental to proposed modifications to the Contract documents described herein.

THIS IS NOT A CHANGE ORDER NOR A DIRECTION TO PROCEED WITH THE WORK DESCRIBED HEREIN.

At Sheets A7.10, AQ1.60, AQ1.80, AQ1.81 make the following revisions:

Delete Rail Type 5 below stairs and provide credit. Refer to sketches **JD-66**, **JD-68**, and **JD-69**. Add steel HSS post-up to plan and section to coordinate with Misc Metal Stair Submittals. Refer to

attached sketches JD-66 and JD-68.

Add custom metal framed, wood top bench under stairs. Refer to attached sketch **JD-67**, **JD-68**, and **JD-69**.

Revise the existing corridor benches at Connector C as shown in attached sketch **JD-67** and **JD-69**. Wall tile shall continue behind bench.


JD-66, JD-67, JD-68, JD-69

Issued by

**DORE + WHITTIER** 

Tara King

Copy: File

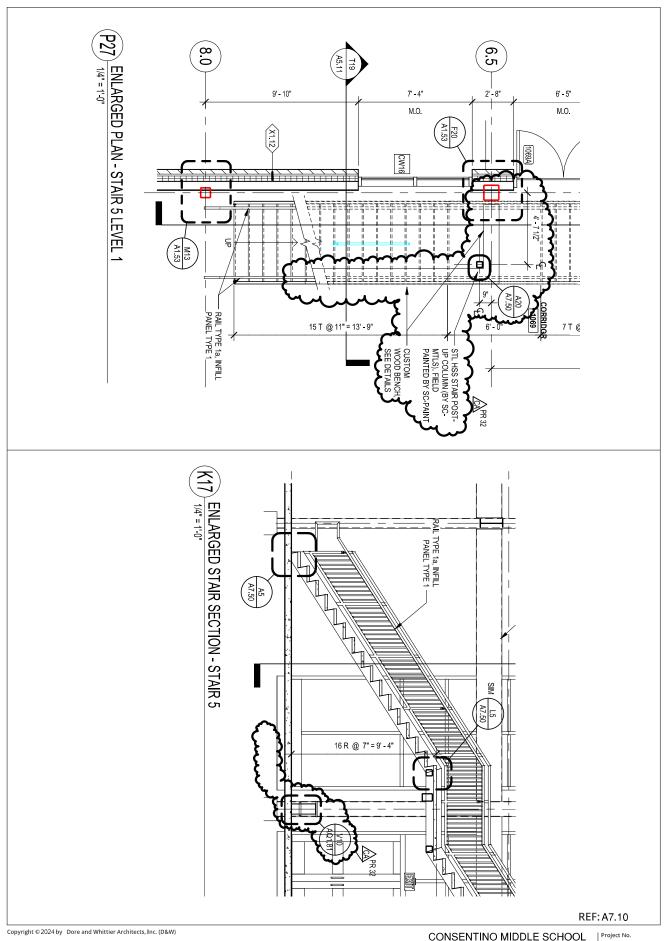


CONSENTINO MIDDLE SCHOOL 685 WASHINGTON STREET HAVERHILL, MA


21-0818

OV DORE + WHITTIER

Sheet Title

CORRIDOR 1069 AND 2022 REVISIONS: ADD UNDER STAIR BENCH / HSS POST-UP

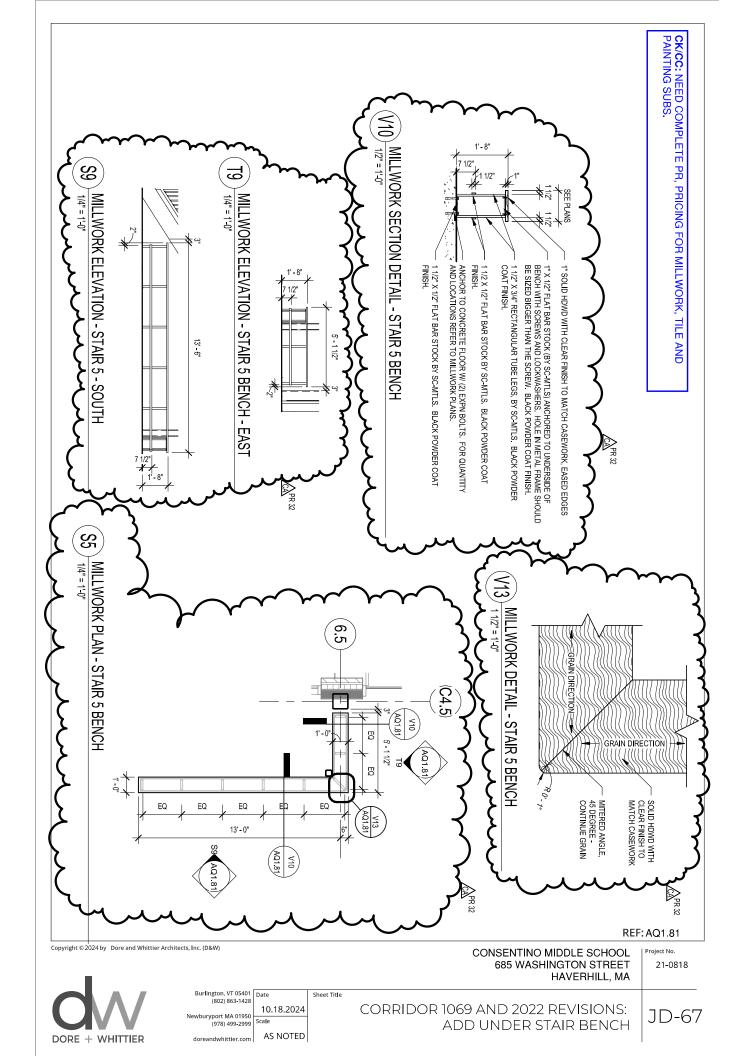

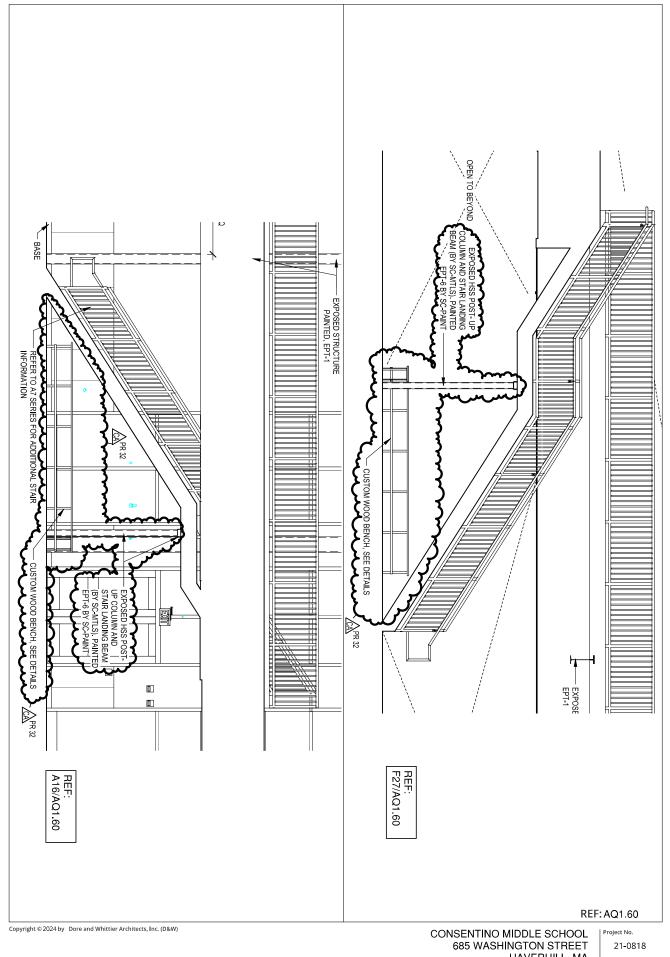


HAVERHILL, MA



Burlington, VT 05401 Date (802) 863-1428 10.18.2024 1/4" = 1'-0"

Sheet Title CORRIDOR 1069 AND 2022 REVISIONS: ADD UNDER STAIR BENCH / HSS POST-UP

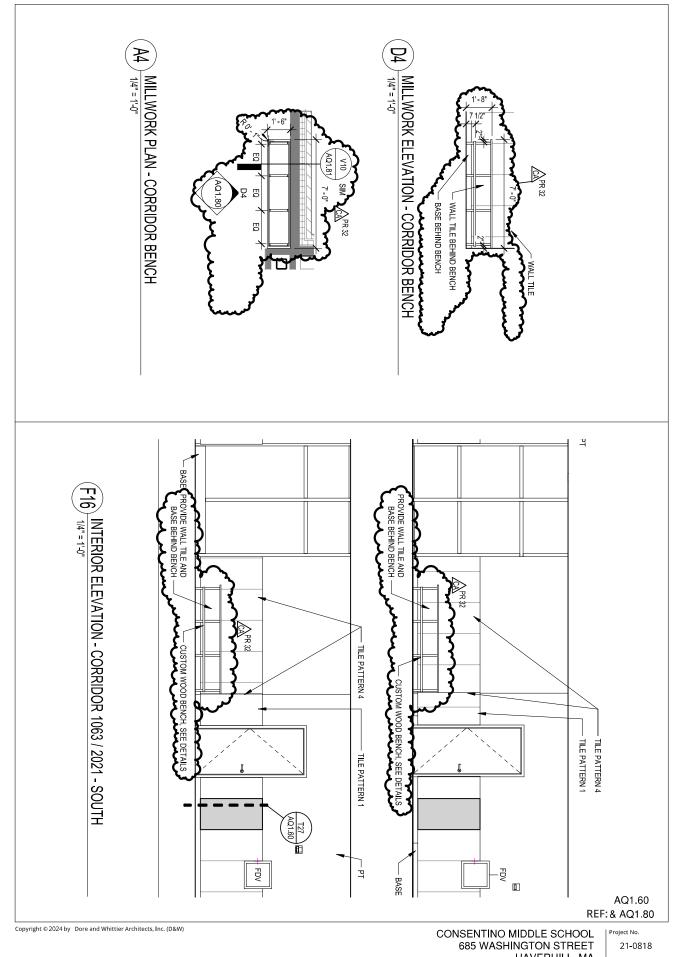

DORE + WHITTIER

Burlington, VT 05401 Date (802) 863-1428 10.18.2024 Newburyport MA 01950 (978) 499-2999 AS NOTED

Sheet Title

HAVERHILL, MA